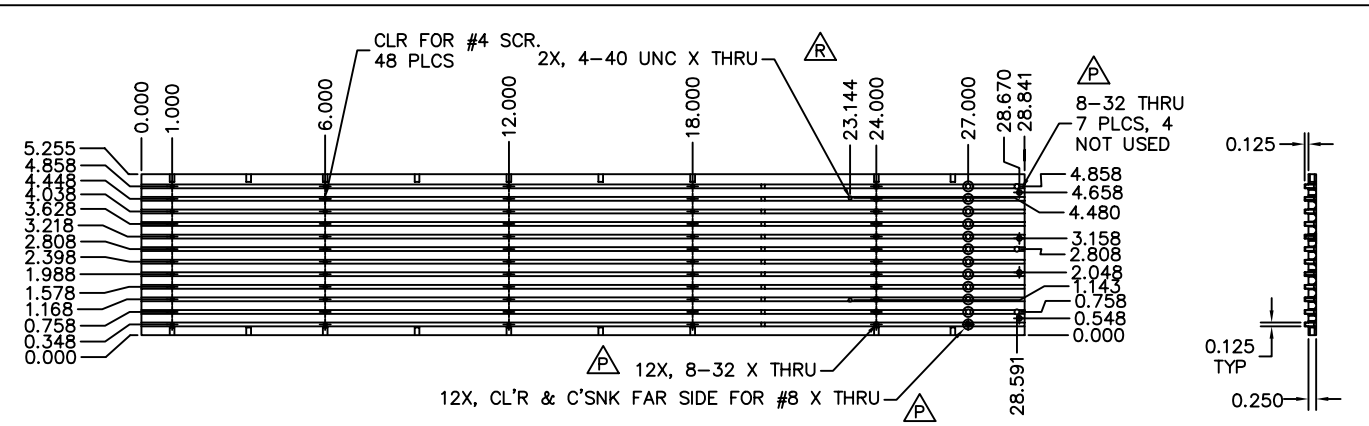

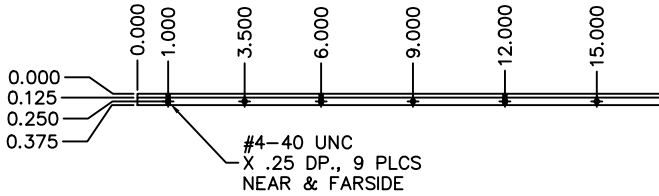

(-1) TOP PLATE

1 REQ'D
MAT'L – 3/8 ALUM PLATE
NEXT ASSEMBLY – D1215-1
SCALE 1/2

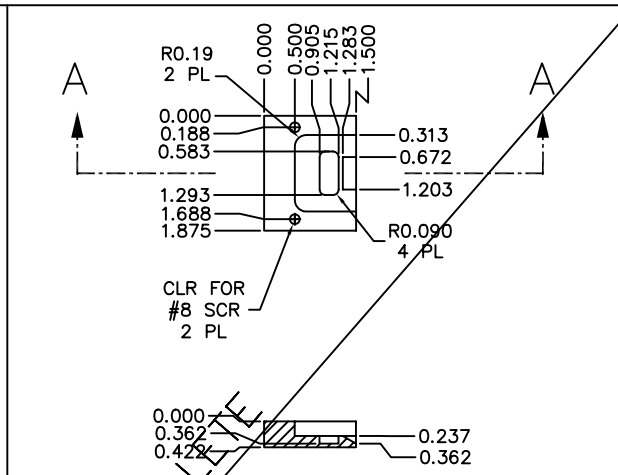

(-4) DOOR LATCH

3 REQ'D
MAT'L – DELRIN

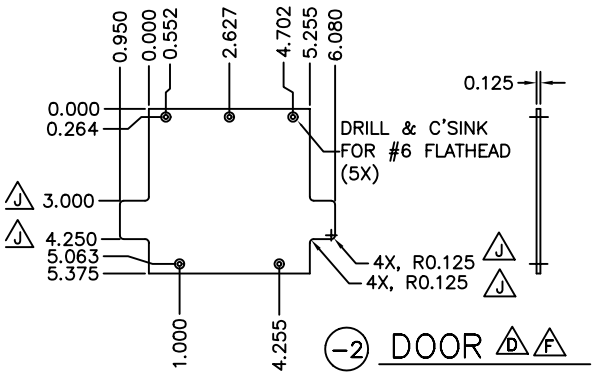

(-2) DOOR

1 REQ'D
MAT'L – ALUMINUM
FINISH – BLACK ANODIZE
NEXT ASSEMBLY – D1215-1
SACLE 1/2

INCHES

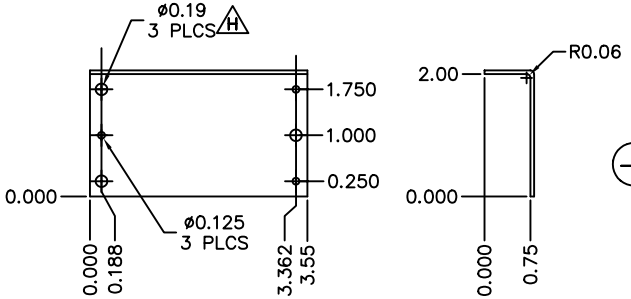

(-3) COVER

1 REQ'D
MAT'L – .06 ALUMINUM
FINISH – BLACK ANODIZE
NEXT ASSEMBLY – D1215-1

H	11/14/00	CAO	ADD HOLES TO ITEM -3
J	11/15/00	VRW	ADD LIMIT SWITCH TRIP BARS -2
K	3/16/01	CAO	REVISED & REDRAWN ITEM -1
M	5/5/01	CAO	ADDED HOLE TO ITEM -3
N	7/19/01	VRW	CHANGE MATERIAL -1
P	11/26/01	VRW	ADD, REVISE HOLES
R	11/26/01	VRW	ADD HOLES
T	11/27/01	CAO	ADDED ITEM 4
U	7/15/02	VRW	CHANGE MATERIAL -1, OBS -4

PART NO.	ITEM	QTY	DESCRIPTION	MATERIAL
TOLERANCES UNLESS OTHERWISE NOTED: DECIMAL X.X ±0.1 in X.XX ±0.01 in X.XXX ±0.005 in X.XXXX±0.0001 in ANGLES ±0.5° FINISH 125 MICRO INCHES BREAK SHARP EDGES AND CORNERS 1/64 MAXIMUM				SCALE FULL

MARK	DATE	DRAWN	CHKD	REVISION
B	12/3/97	LCC		AS BUILT TEST PART
C	1/8/98	VRW		ADD GROOVE FOR SENSOR
D	1/22/98	VRW		UPDATE
E	2/17/98	VRW		CORRECT DIMENSION
F	2/26/98	VRW		REDRAW -1, -2
G	6/21/99	VRW		SHORTEN ITEM -1

PART NO.	ITEM	QTY	DESCRIPTION	MATERIAL

UNIVERSITY OF CALIFORNIA
LICK OBSERVATORY

KECK/DEIMOS

CASSETTE
DETAILS

DRAWN	E.J.	2/1/97	DWG. No. D1217.U
CHKD	C.A.O.	2/19/97	
QA/QC			DATE