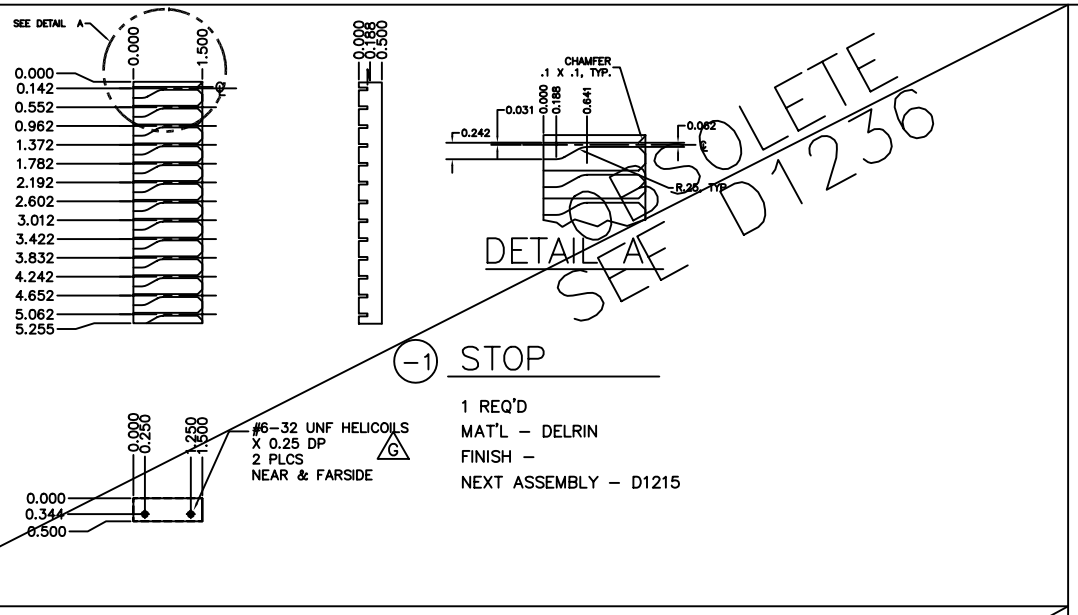

-1 STOP

1 REQ'D
MAT'L – DELRIN
FINISH –
NEXT ASSEMBLY – D1215

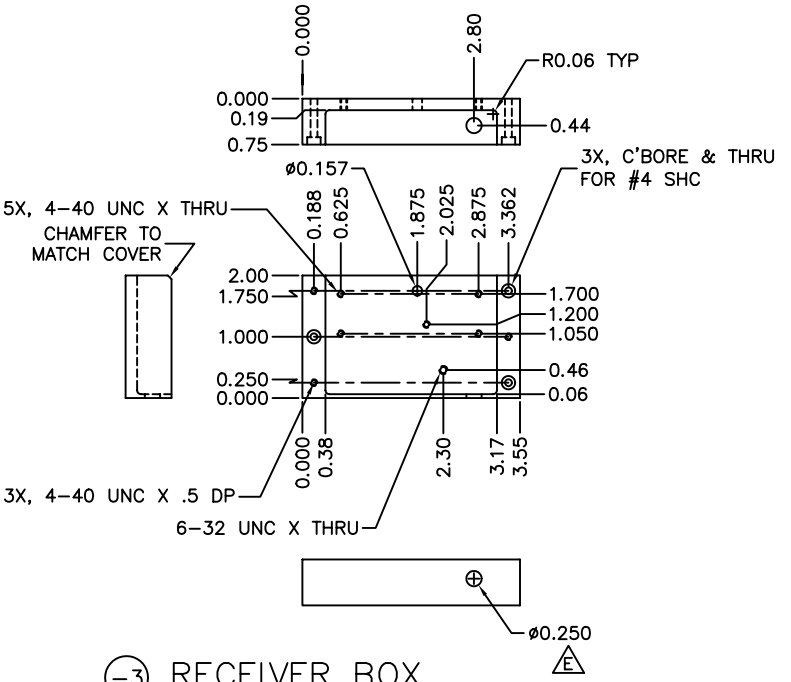

-3 RECEIVER BOX

1 REQ'D
MAT'L – ALUMINUM
FINISH – BLACK ANODIZE
NEXT ASSEMBLY – D1215

-2 HINGE BLOCK

1 REQ'D
MAT'L – ALUMINUM
FINISH – BLACK ANODIZE
NEXT ASSEMBLY – D1215

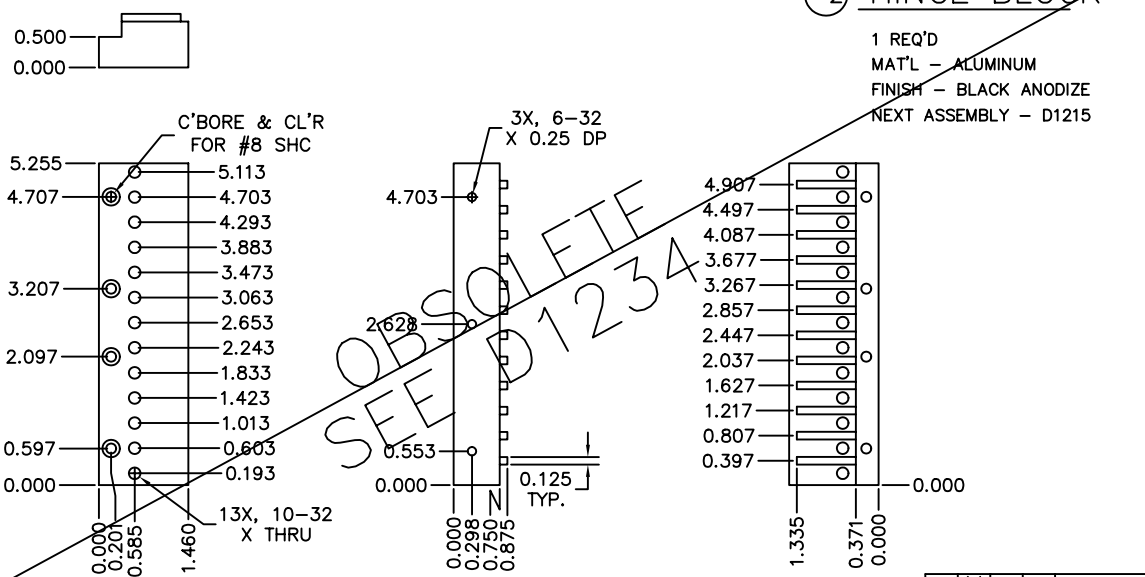

INCHES

REV	DATE	DRWN	CHKD	REVISION
J	6/28/00	VRW	VRW	OBSOLETE ITEM -1. SEE D1236-1
H	6/28/00	VRW	VRW	REDESIGN ITEM -2
G	6-23-98	CWC		-2 HOLE DIMS & CUTOUT, -1 DIM

PART NO.	ITEM	QTY	DESCRIPTION	MATERIAL

TOLERANCES UNLESS OTHERWISE NOTED:
DECIMAL .X ±0.1 In; .XX ±0.01 In; .XXX ±0.005 In; .XXXX±0.0001 In
ANGLES ±0.5°
FINISH 125 MICRO INCHES
BREAK SHARP EDGES AND CORNERS 1/64 MAXIMUM.

SCALE: N/A

PART NO.	ITEM	QTY	DESCRIPTION	MATERIAL

UNIVERSITY OF CALIFORNIA
LICK OBSERVATORY

KECK/DEIMOS

CASSETTE
DETAILS

MARK	DATE	DRWN	CHKD	REVISION
A	7/16/97	EL		UPDATE
B	9/10/97	VRW		CORRECT DETENT HOLES
C	12/1/97	LCC		AS BUILT TEST PART
D	1/22/98	VRW	VRW	MOVE 13 HOLES -2 PART, ADD -3
E	2/27/98	VRW	VRW	CORRECT -2, ADD DIM -3
F	3/16/98	VRW	VRW	MOVE HOLE LOCATION ITEM -2

DRWN	E.J.	2/1/97	MATL
CHK'D	C.A.O.	2/19/97	APPROVED
			DATE

UNITOO

DWG. NO. D1218J